



- CONSTRUCTION NOTES**
- CONSTRUCTION SHALL BE IN ACCORDANCE WITH STANDARD SPECIFICATIONS FOR PUBLIC WORKS CONSTRUCTION, 1976 EDITION.
 - PAVEMENT REPLACEMENT ON VICTORIA AVE TO BE 2 1/2" A.C. ON 4" CLASS II BASE.

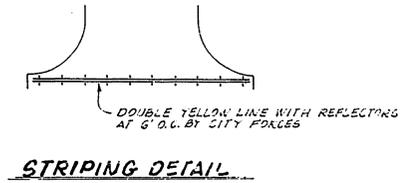

CITY OF RIVERSIDE PUBLIC WORKS DEPARTMENT		"AS BUILT" VICTORIA AVENUE FLOOD DAMAGE REPAIR BETWEEN GIBSON & JACKSON STREETS	ACCOUNT NO. 30-575-291-30 R-2165 SHEET 1 OF 1 FILE NO.
DATE: 11/15/75 APPROVED BY: [Signature] PUBLIC WORKS DIRECTOR	DATE: 11/15/75 APPROVED BY: [Signature] PUBLIC WORKS DIRECTOR	HORIZ. SCALE: 1" = 20' VERT. SCALE: 1" = 2'	

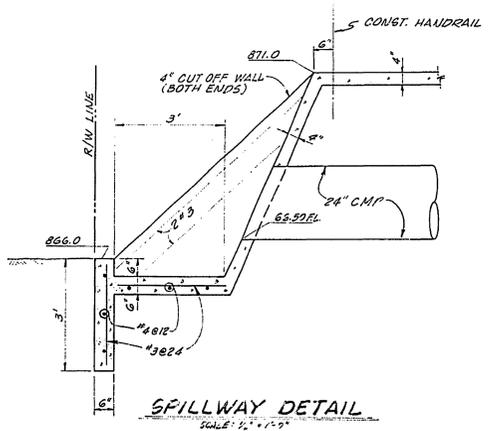